

KEY:

PILE DETERIORATION:

- (A) Pile is OK - Minimal Damage (Typical at all interior piles)
- (B) Pile has Some Rot, mainly above grade
- (C) Pile has significant Rot and likely needs to be replaced

BEAM/FRAMING NOTE:


- ~~1 GL Beam is offset from Pile CL~~
- ~~2 Beam has signs of Rot/Deterioration~~
- ~~3 Framing shows signs of Rot/Deterioration~~

BEAM repair completed 10/24

Existing Pile Layout Plan and Damage Key Plan
September 20, 2024



I.L. GROSS
STRUCTURAL
ENGINEERS

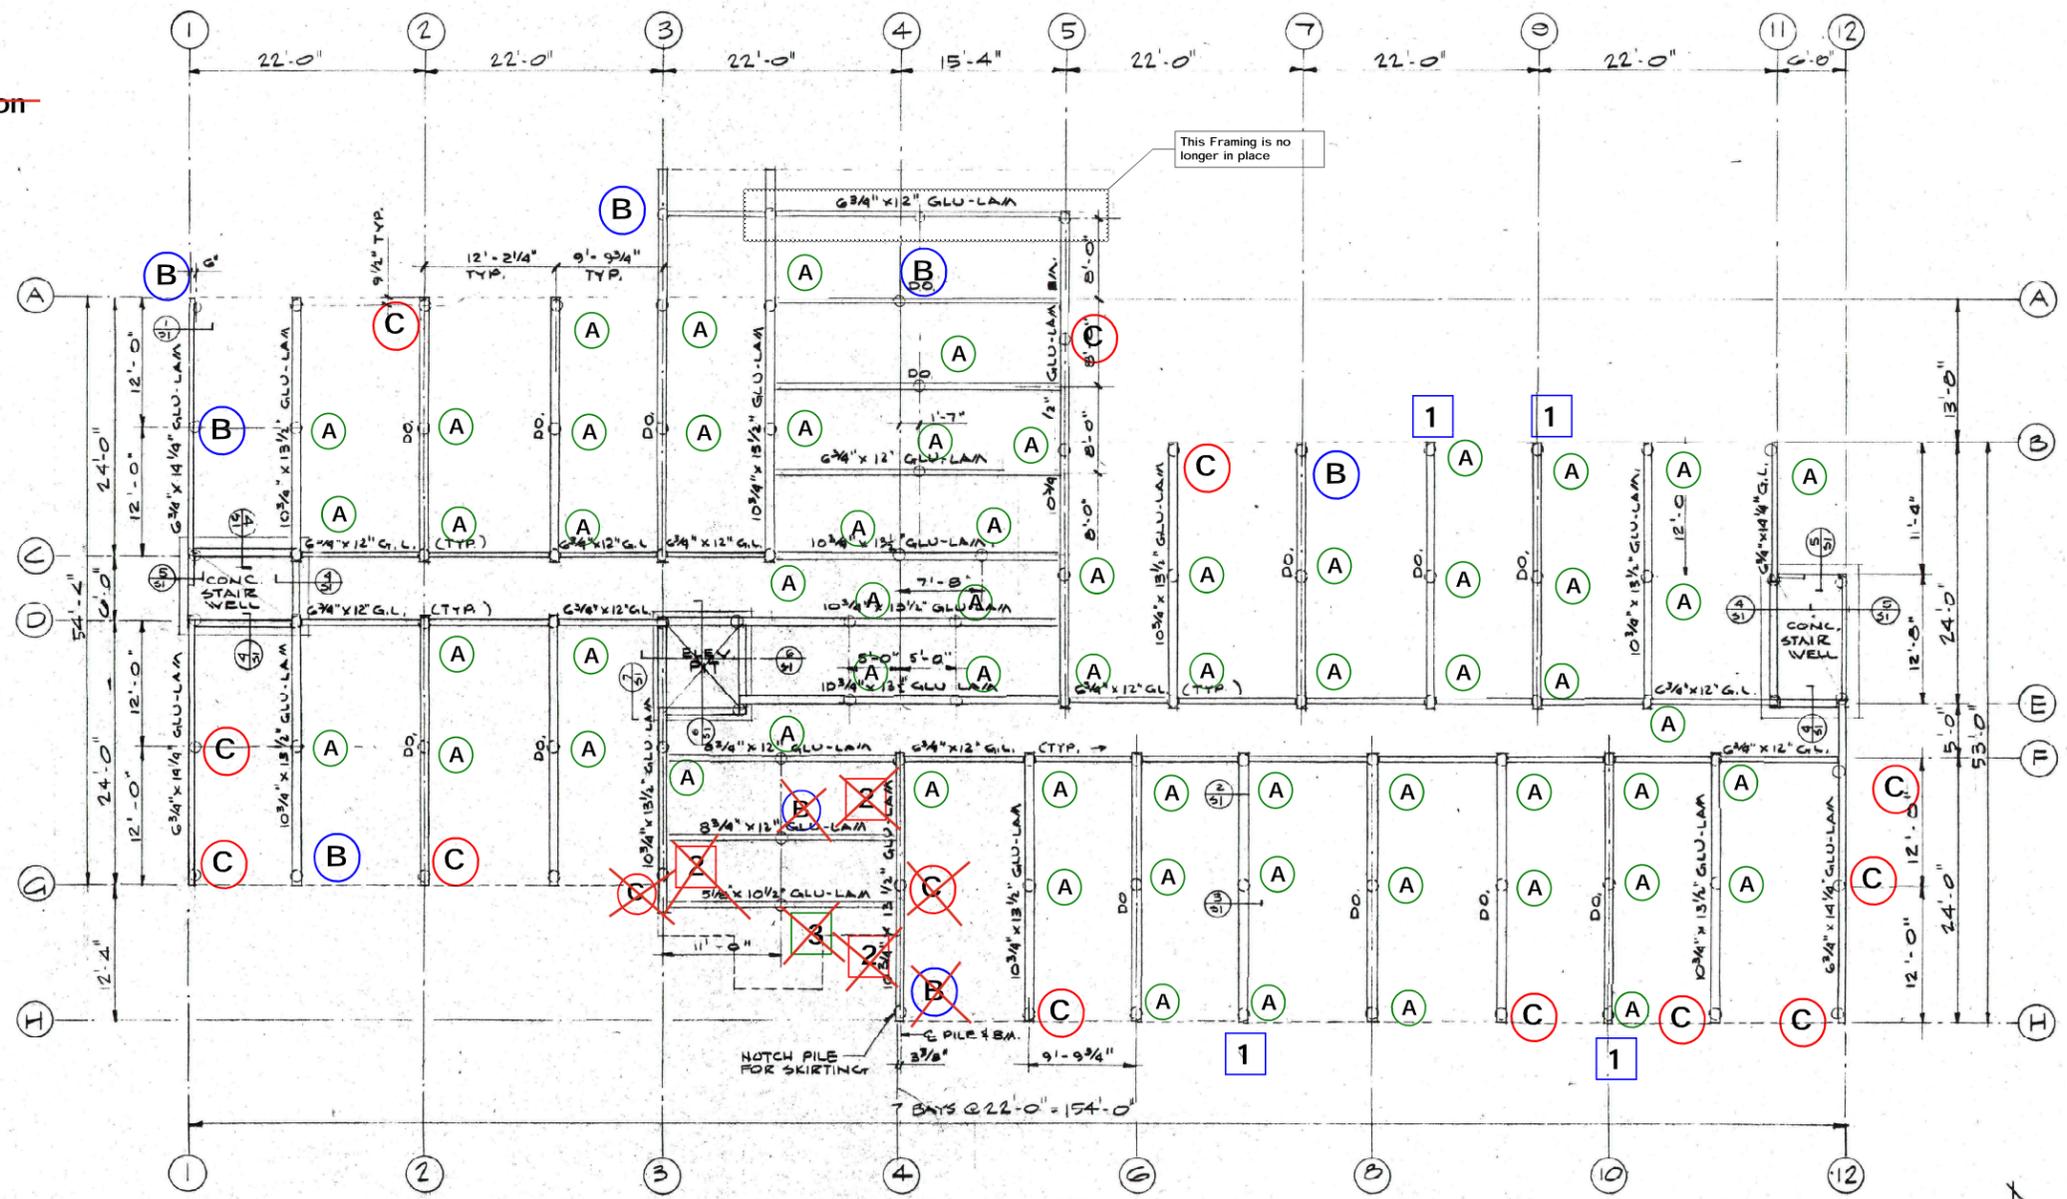

PIILING PLAN
SCALE: 1/8" = 1'-0"



NORTHWEST DESIGN ASSOCIATES
ARCHITECTS AND ENGINEERS
5115 3RD AVENUE SEATTLE
206/851-2485



PIILING PLAN & DETAILS, STRUCTURAL NOTES
35 UNIT APARTMENT
FOR THE HIGH DEVELOPMENT CO.
TO BE BUILT AT 6TH & BELL STREETS, RAYWALD WASH

DATE: 9-25-24
REV:
SHEET: 1